
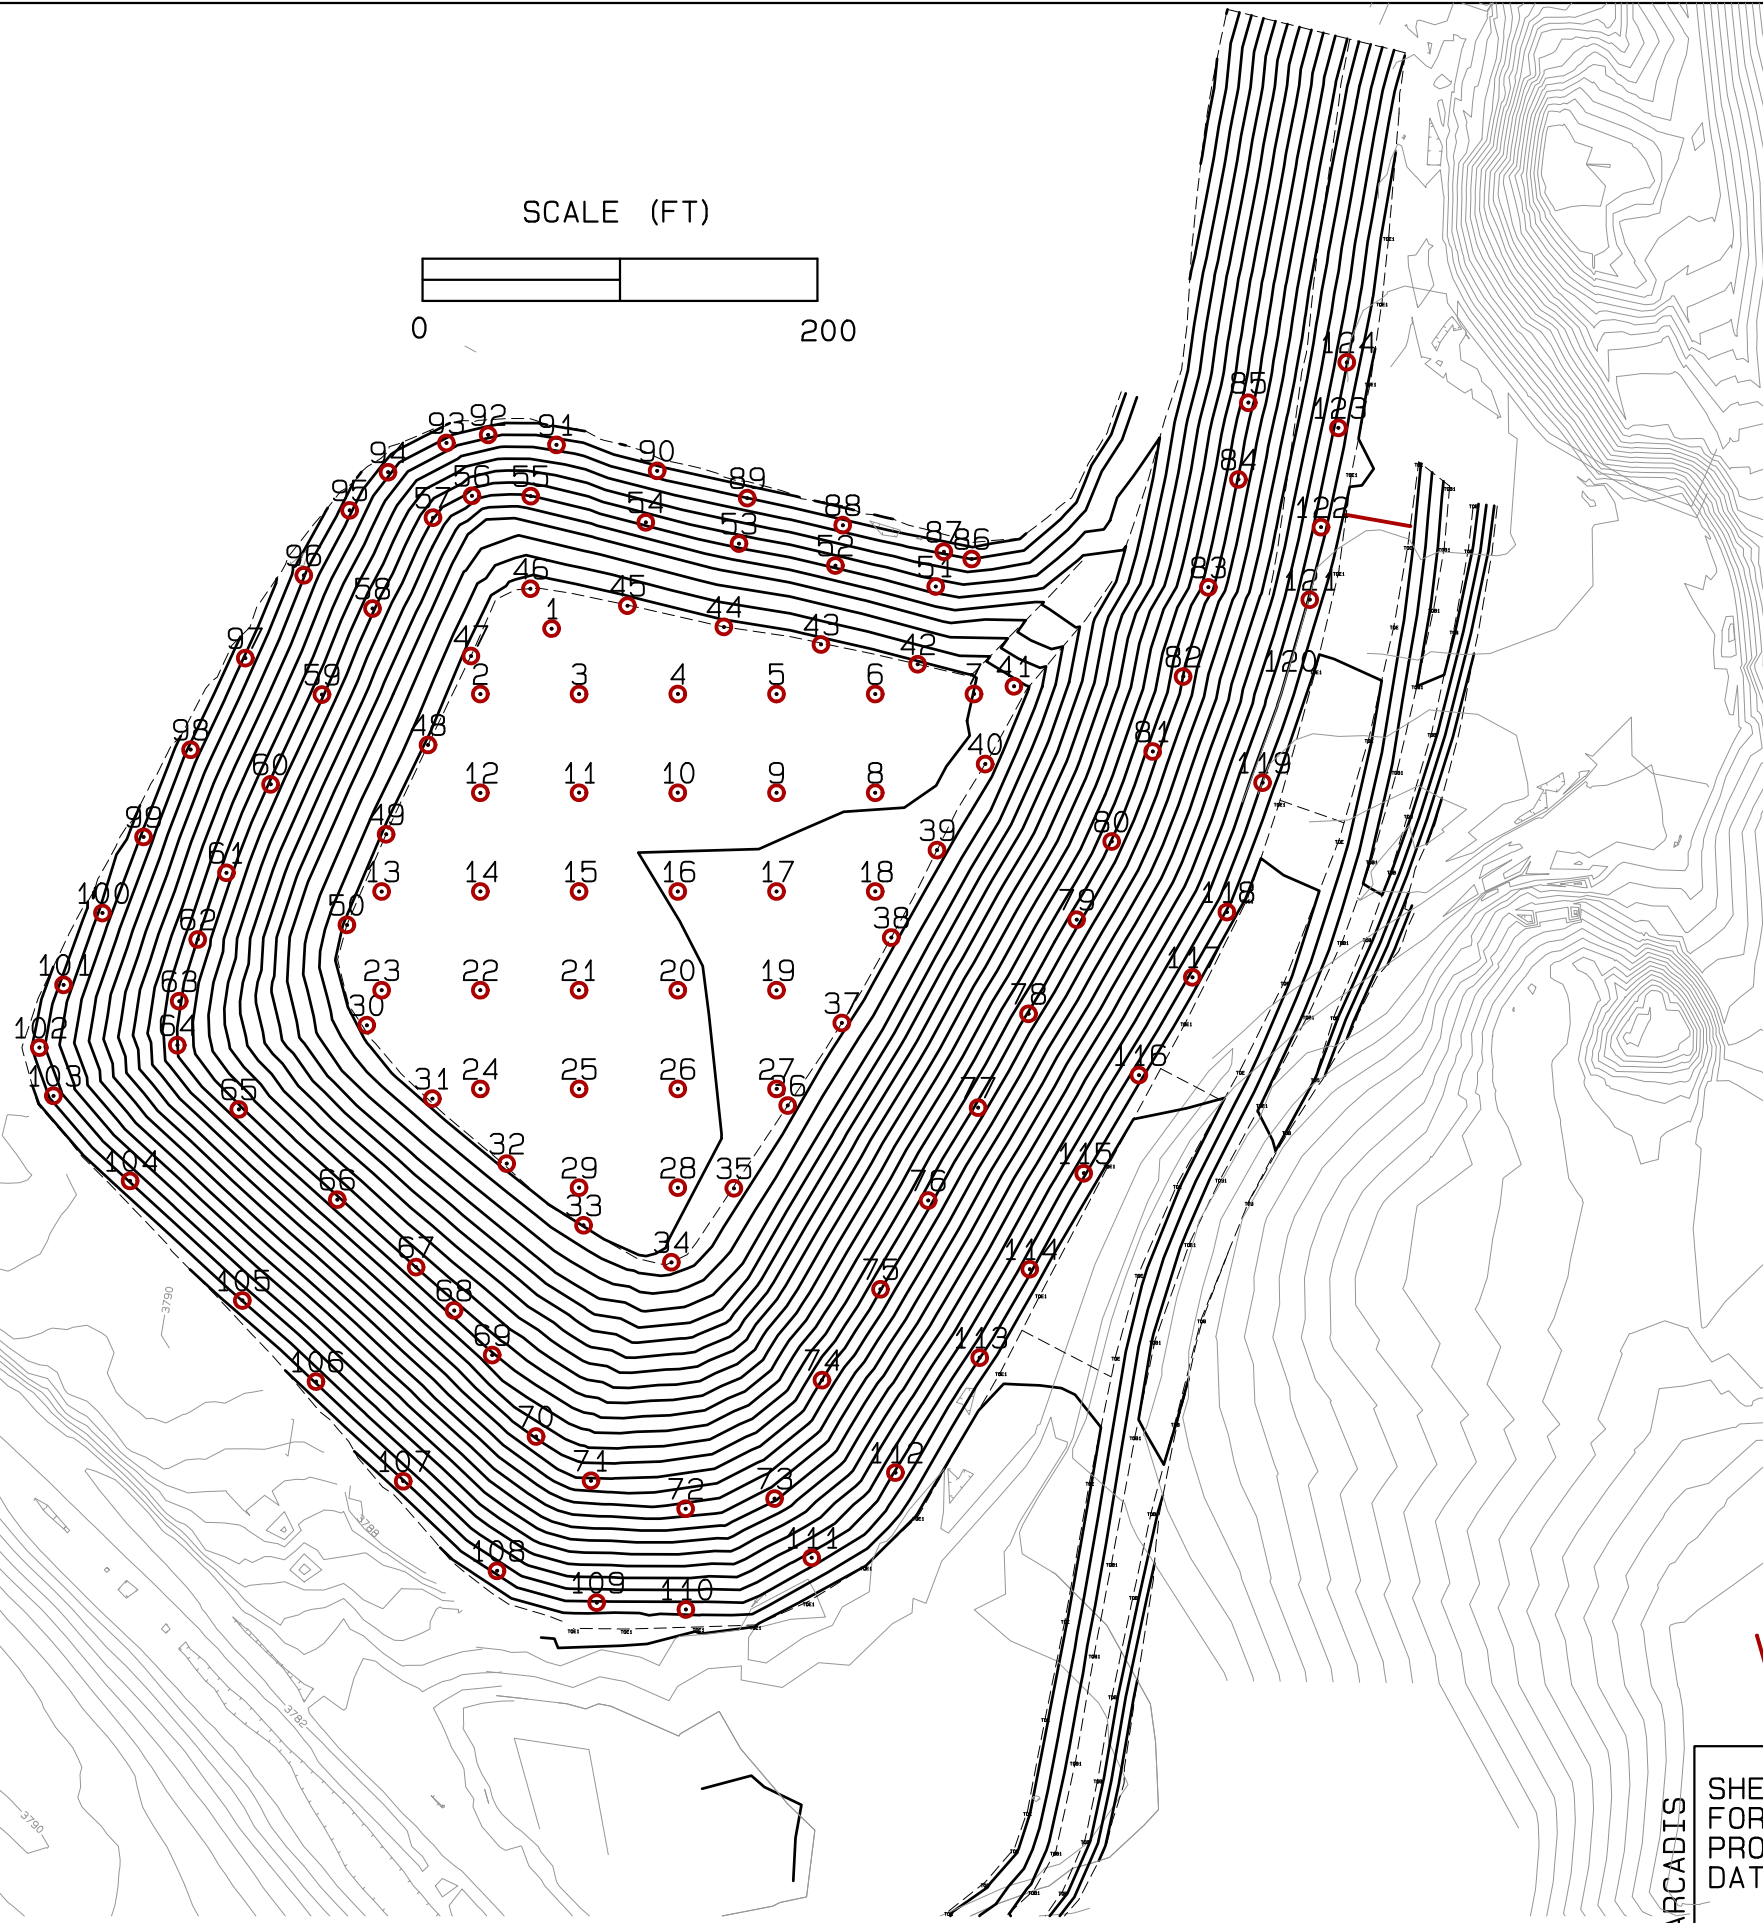


SCALE (FT)

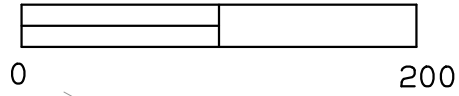

- EXISTING GRADE CONTOURS
- AS-BUILT FINAL GRADE CONTOURS (2' CONTOUR INTERVAL)

ARCADIS

SHEET TITLE: FINES PILE CQA CONTROL POINTS FIGURE
FORMER ASARCO EL PASO SMELTER SITE
PROJECT LOCATION: EL PASO, TEXAS
DATE: 01/25/17 BY: NWF

FIGURE
1